

ADDENDUM NO. 20

**CITY OF HIALEAH
PALM CENTER PARKING GARAGE
265 PALM AVE
HIALEAH, FLORIDA**

APRIL 15, 2011

TO ALL CONCERNED

The original Contract Documents, for the Project entitled **CITY OF HIALEAH – PALM CENTER PARKING GARAGE - PLUMBING, BID NO. 2009/10-3230-00-091** is amended as noted in this Addendum No. 20.

This **Addendum No. 20** consists of 1 Typed Pages, 0 Sketches, 0 Attachments and 0 Drawings. All other items and conditions of the original Contract Documents shall remain unchanged. This Addendum shall become a part of the Contract Documents.

Approved for issue:  Date: April 15, 2011
Oniel E. Toledo - Project Manager

ACKNOWLEDGEMENT

Receipt of this **Addendum No. 20** shall be acknowledged in the space provided on the ADDENDUM RECEIPT FORM (ARF) (copy attached) now a part of the Contract Documents and to be faxed immediately to City of Hialeah @ (305) 687-2642 and submitted with sealed bids.

IN THE CONTRACT DOCUMENTS:

1. Please revise “ADVERTISEMENTS AND INVITATION FOR BIDS” forms as follows:

Sealed, written bids will be received by the office of the City Clerk of the City of Hialeah, Florida, 501 Palm Avenue until 11:00 a.m., Thursday, April 21, 2011, at which time all bids will be publicly opened and read aloud in the Council Chambers for furnishing the following:

PLUMBING, BID NO. 2009/10-3230-00-091

DRAWINGS:

- P-1 Revised 2/9/11 PDF
- P-2 Revised 2/9/11 PDF
- P-3 Revised 2/9/11 PDF
- P-4 Revised 2/9/11 PDF



City of Haleah

Construction and Maintenance
 900 East 56th Street Bldg. 1
 HALEAH, FLORIDA 33013
 Tel: (305) 687-2682
 Fax: (305) 687-2642



City Architect
REYNALDO A GOMEZ
 L.I.C. AR0013736

PROJECT No.
1004

**PALM CENTER
 GARAGE**

PROJECT ADDRESS:
 HALEAH, FL

CONSULTANTS

GURROLA & ASSOCIATES P.A.
 P.E. No. 82285
 L.E. No. 12520
 Prof. Engineer

SEAL


CA 00000112

NATIONAL BOARD OF EXAMINERS
 PROFESSIONAL ENGINEERS
 BOARD OF REGISTRATION
 1000 N. GULF BLVD., SUITE 1000
 TAMPA, FLORIDA 33604-2000

No	DATE	REVISION
1	8/3/10	ARCH. CHANGES
2	9/11	B. D. COMMENTS

DATE: 05-12-2010
 SCALE: AS SHOWN
 DRAWN BY: AS SHOWN
 CHECKED BY: R.G.

This drawing is property of the City of Haleah and is not to be reproduced or copied in whole or part. It is not to be used on any other project and is to be returned upon request.

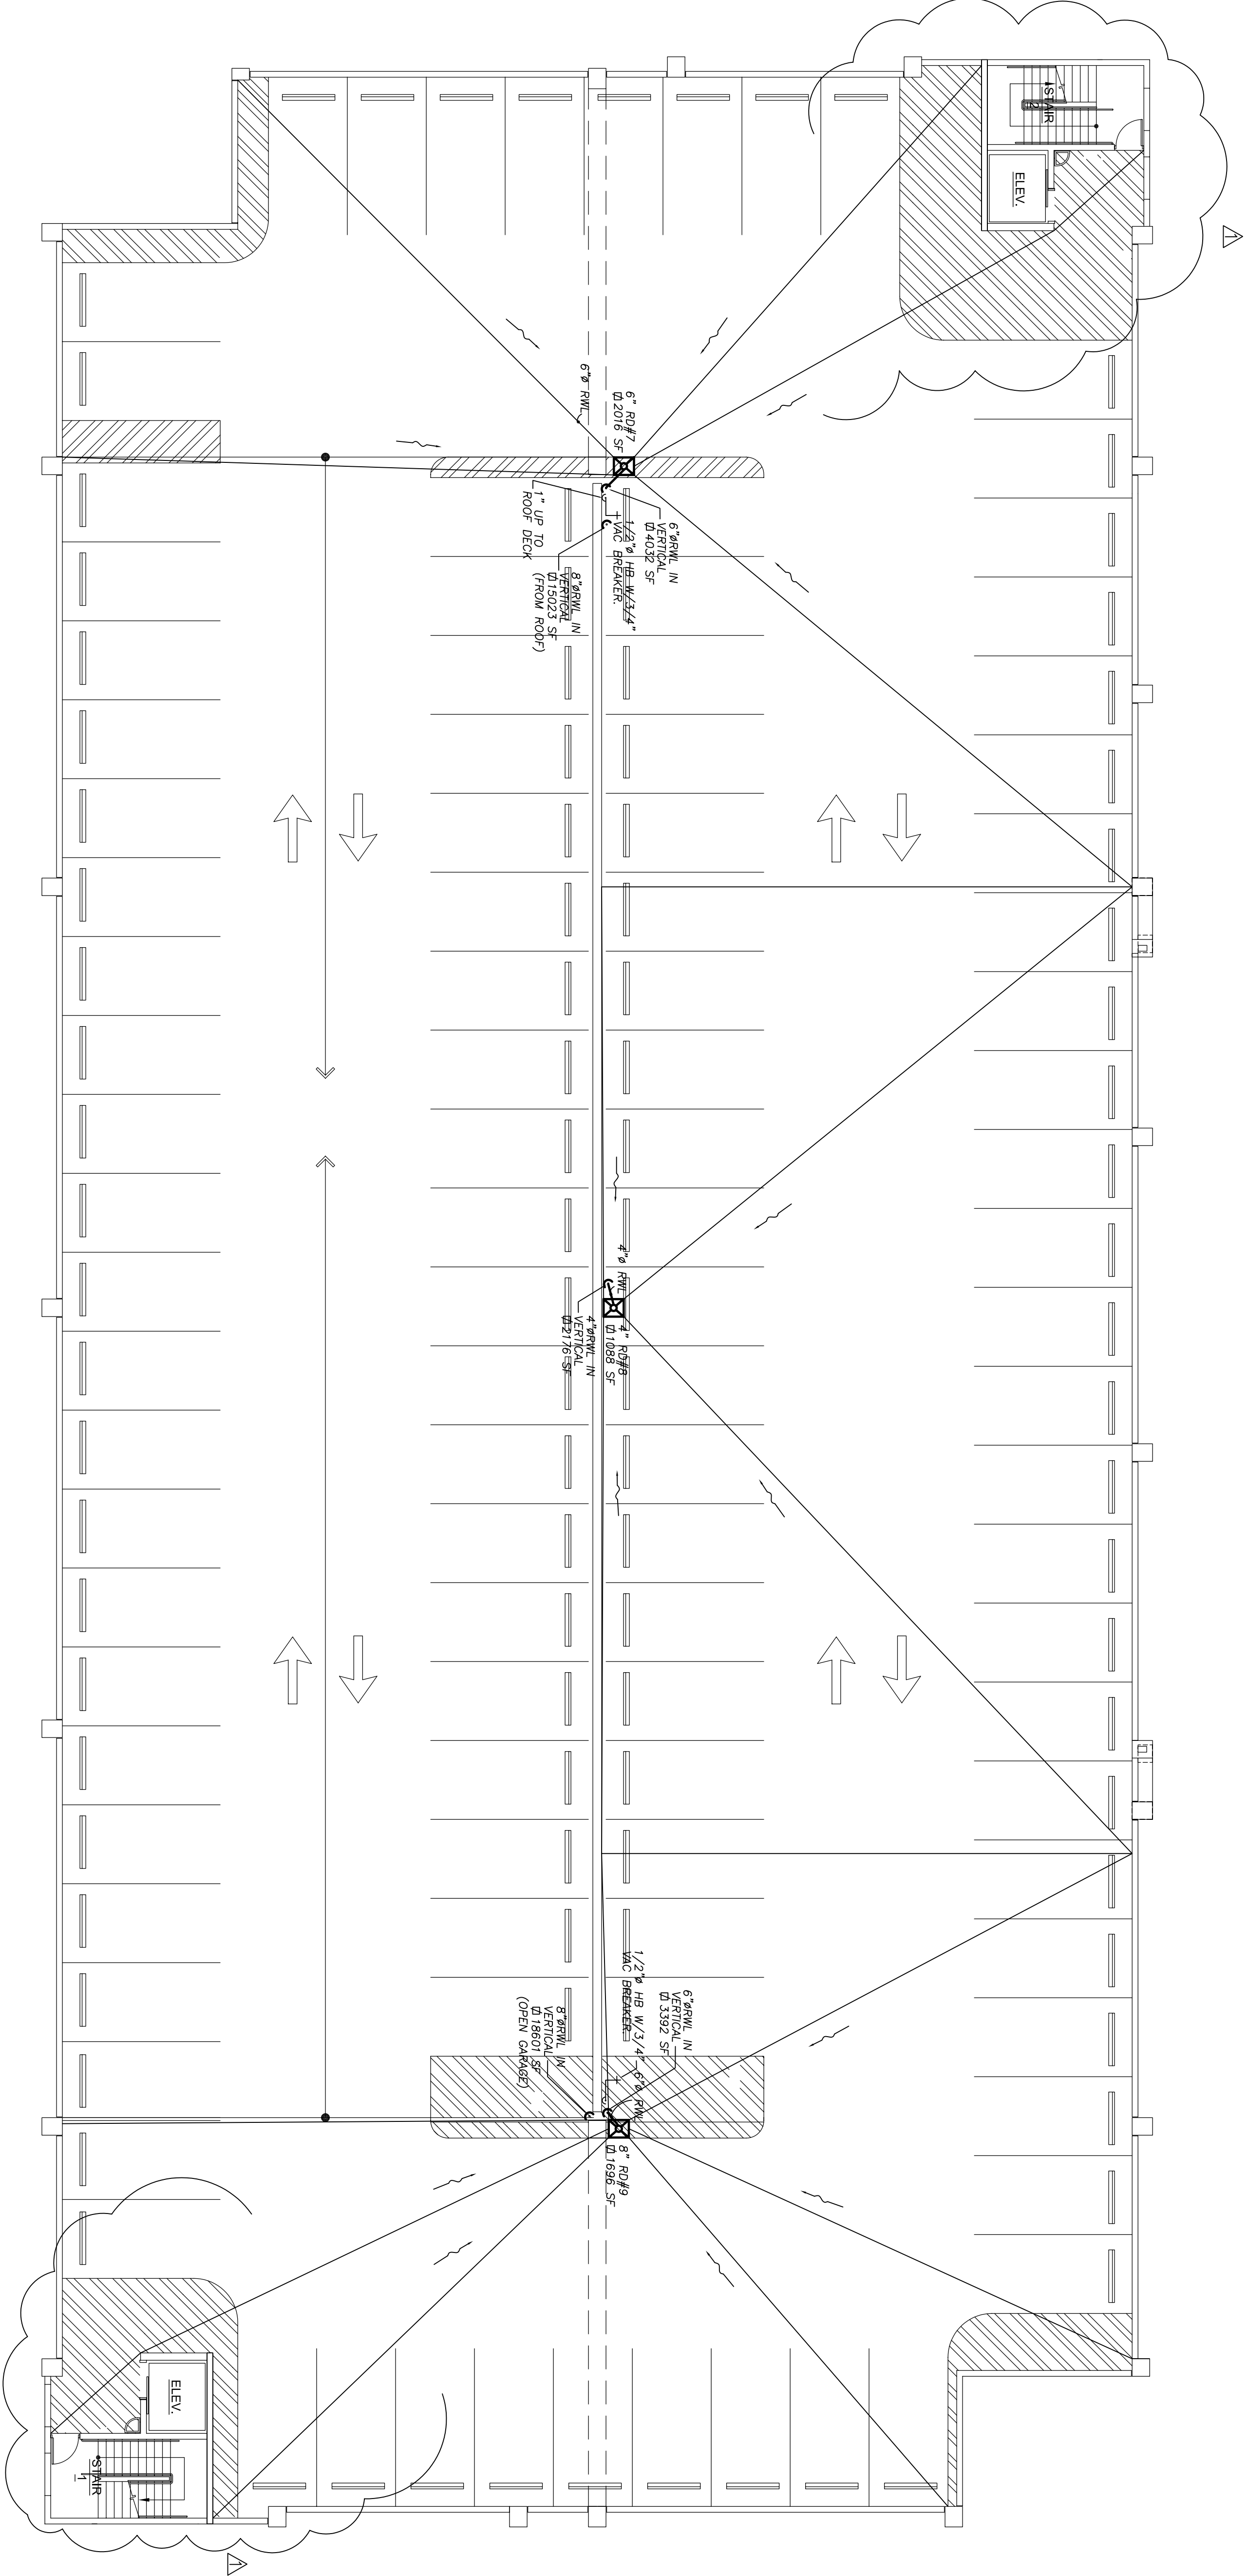

SECOND FLOOR PLUMBING & DRAINAGE PLAN
 SCALE: 3/32" = 1'-0"



City of Hialeah

Construction and Maintenance
 900 East 56th Street Bldg. 1
 HIALEAH, FLORIDA 33013
 Tel: (305) 687-2682
 Fax: (305) 687-2642



City Architect
REINALDO A GOMEZ
 L.I.C. AR0013736

PROJECT No.
1004

**PALM CENTER
 GARAGE**


PROJECT ADDRESS:
 HIALEAH, FL

CONSULTANTS
GURPOLA & ASSOCIATES P.A.
 P.E. No. 82285
 Prof. Engineer
 NATIONAL BOARD OF EXAMINERS
 1000 N. W. 10th Street
 MIAMI, FLORIDA 33136, USA
 (305) 400-1112
 FAX: (305) 400-1113



NO.	DATE	REVISION
1	8/3/10	ARCH. CHANGES
2	9/11	B. D. COMMENTS

DATE: 05-12-2010
 SCALE: AS SHOWN
 DRAWN BY: AS SHOWN
 CHECKED BY: R.G.

This drawing is property of the City of Hialeah and is not to be reproduced or copied in whole or part. It is not to be used on any other project and is to be returned upon request.

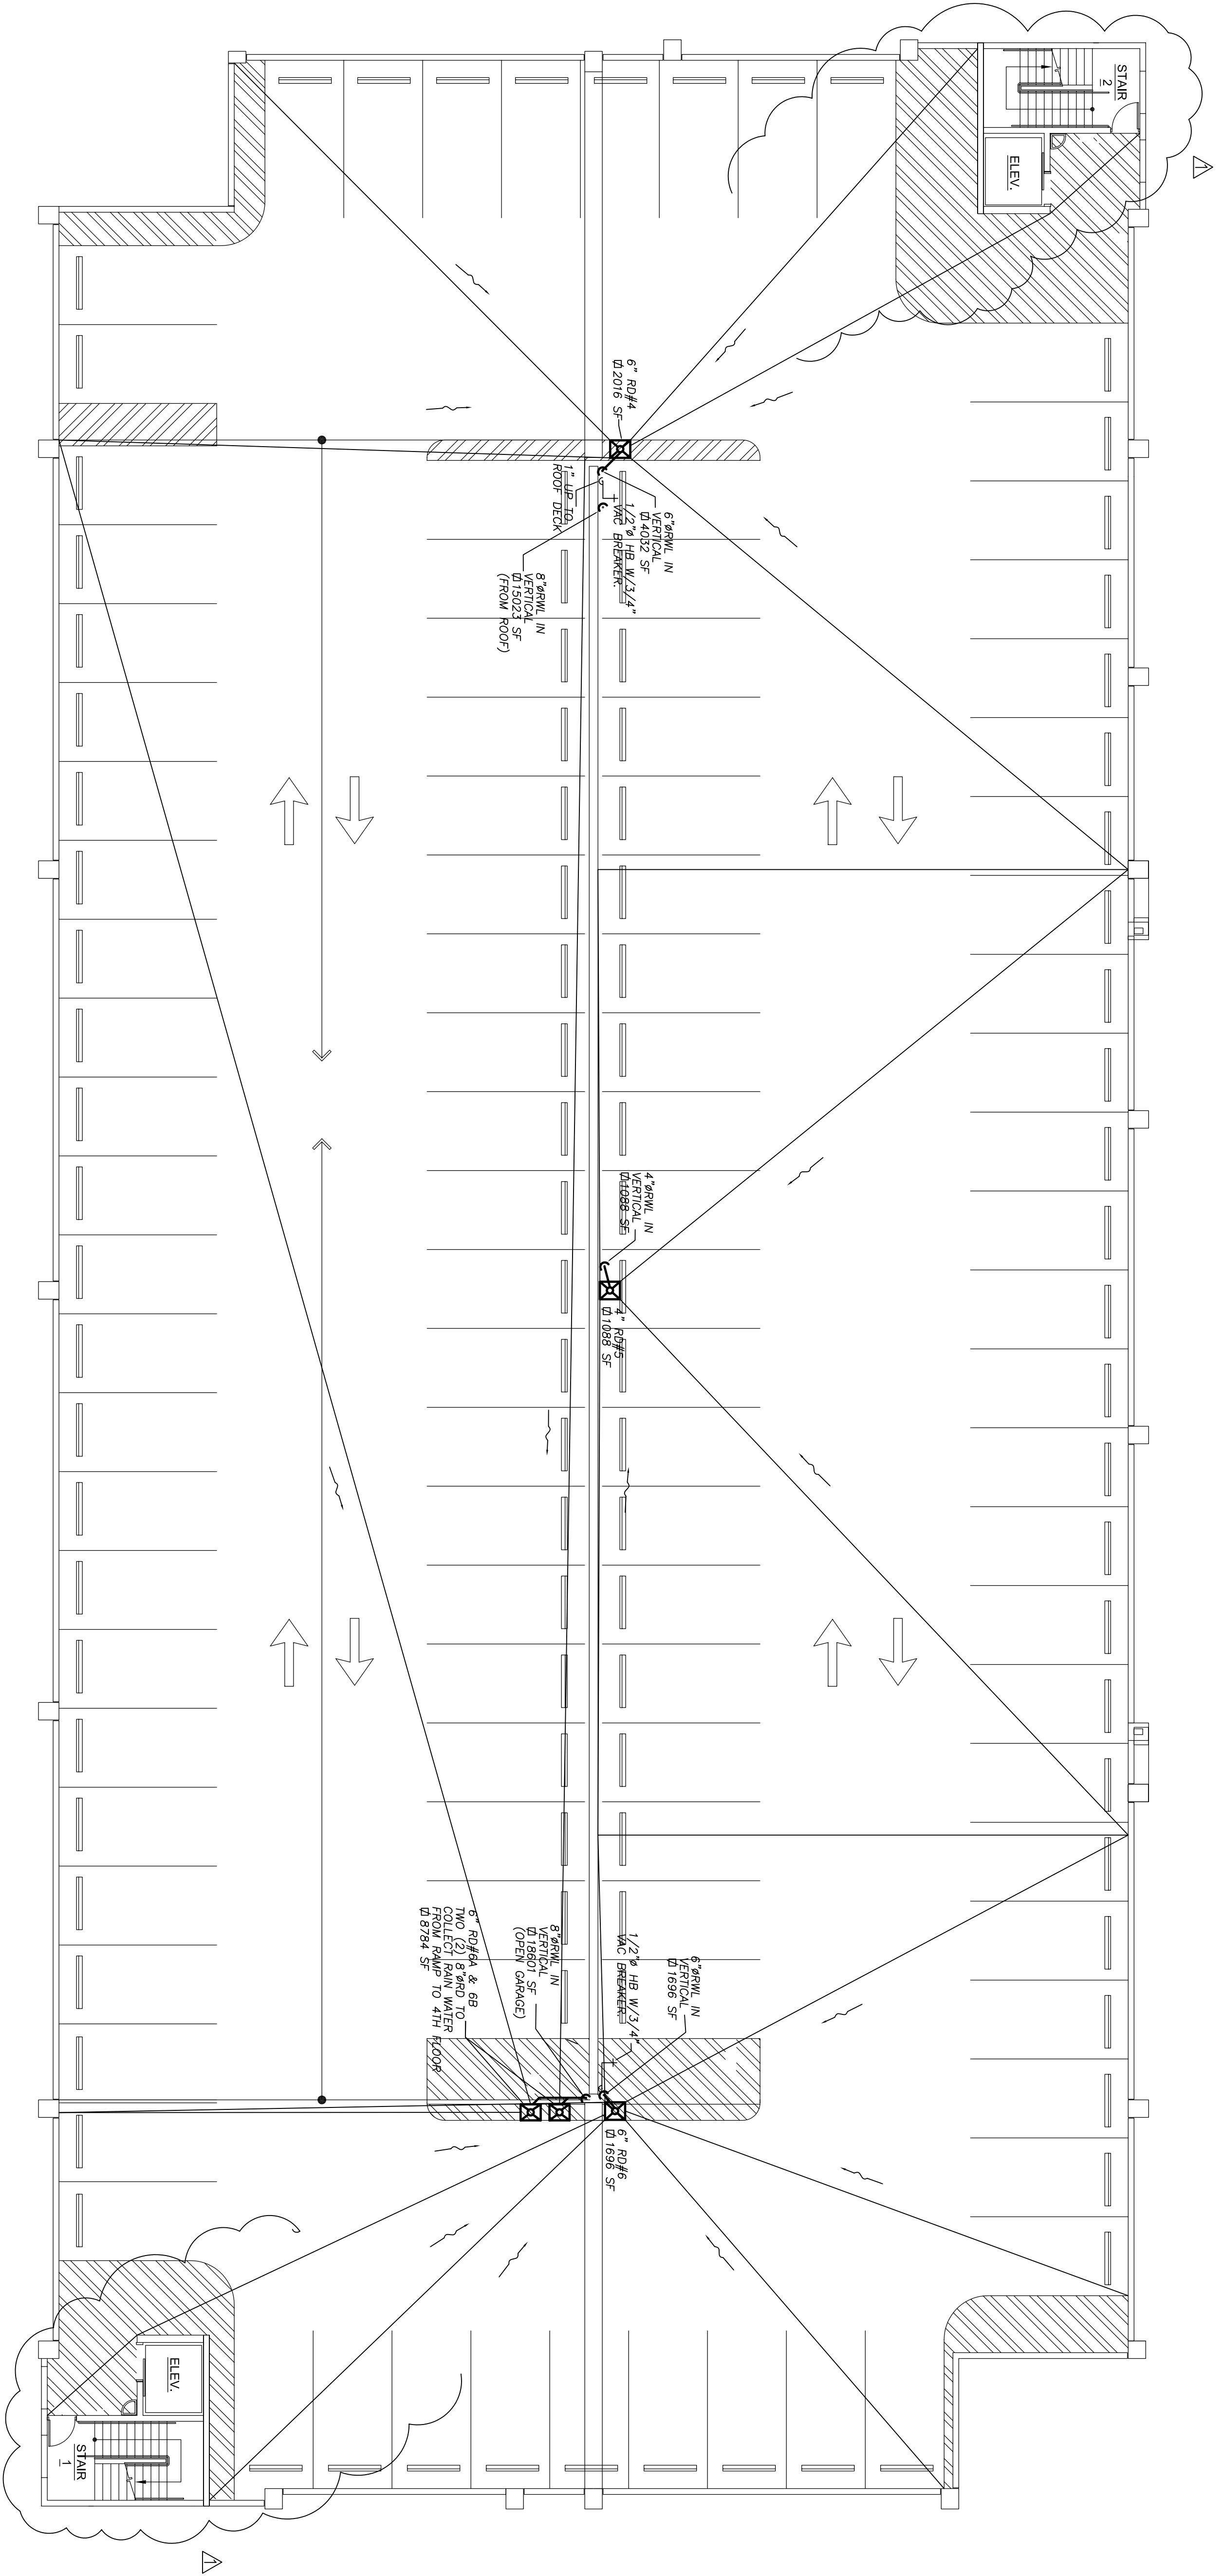


THIRD FLOOR PLUMBING & DRAINAGE PLAN
 SCALE: 3/32" = 1'-0"

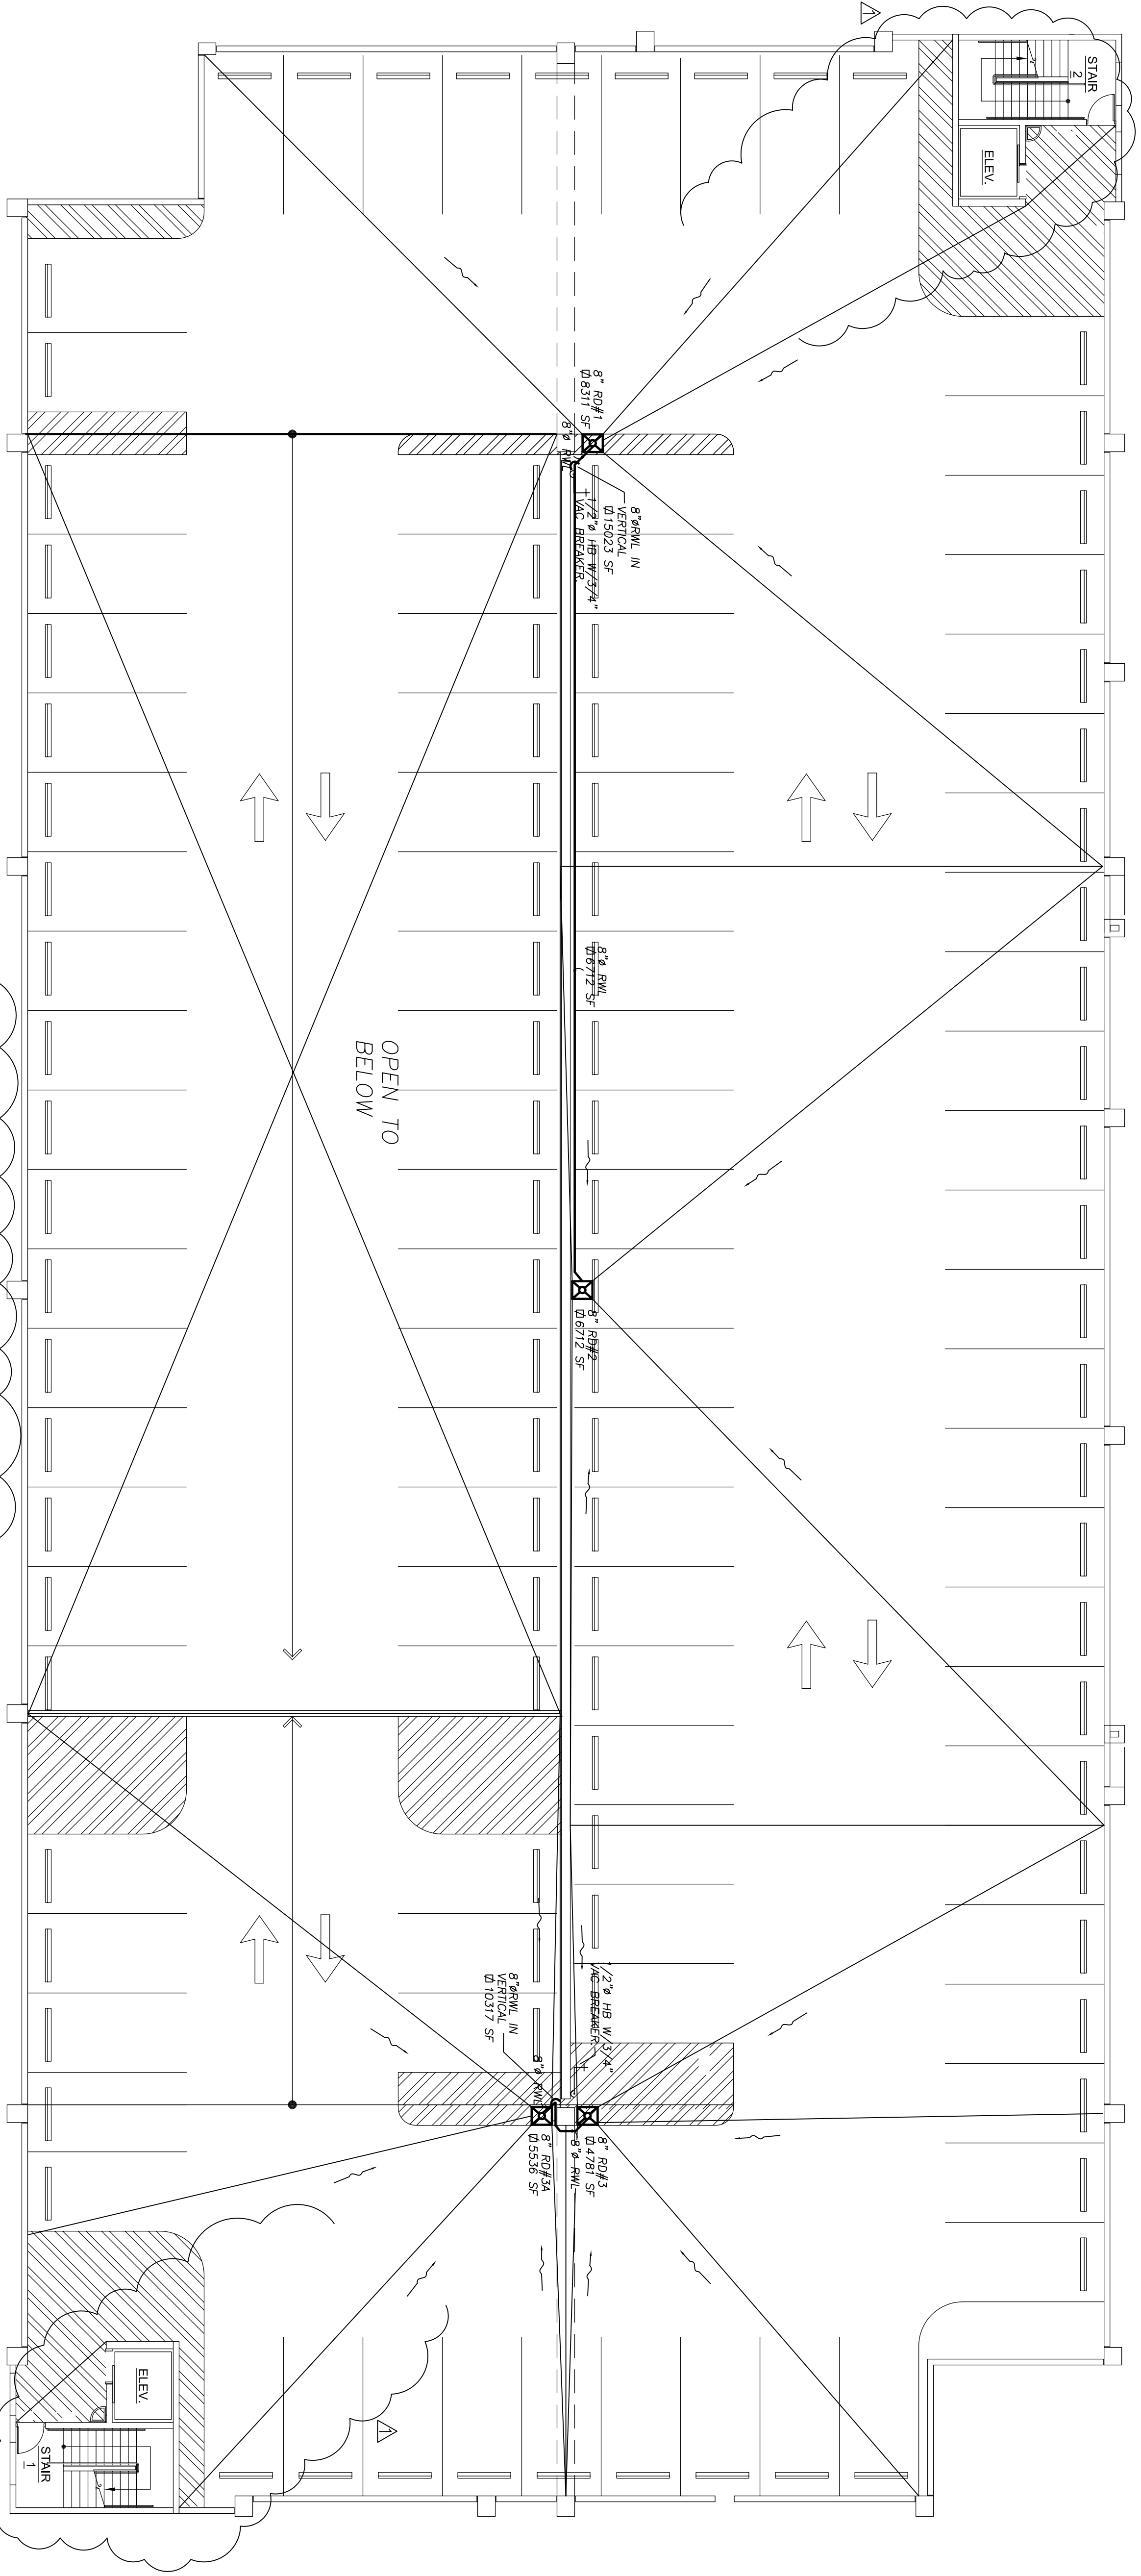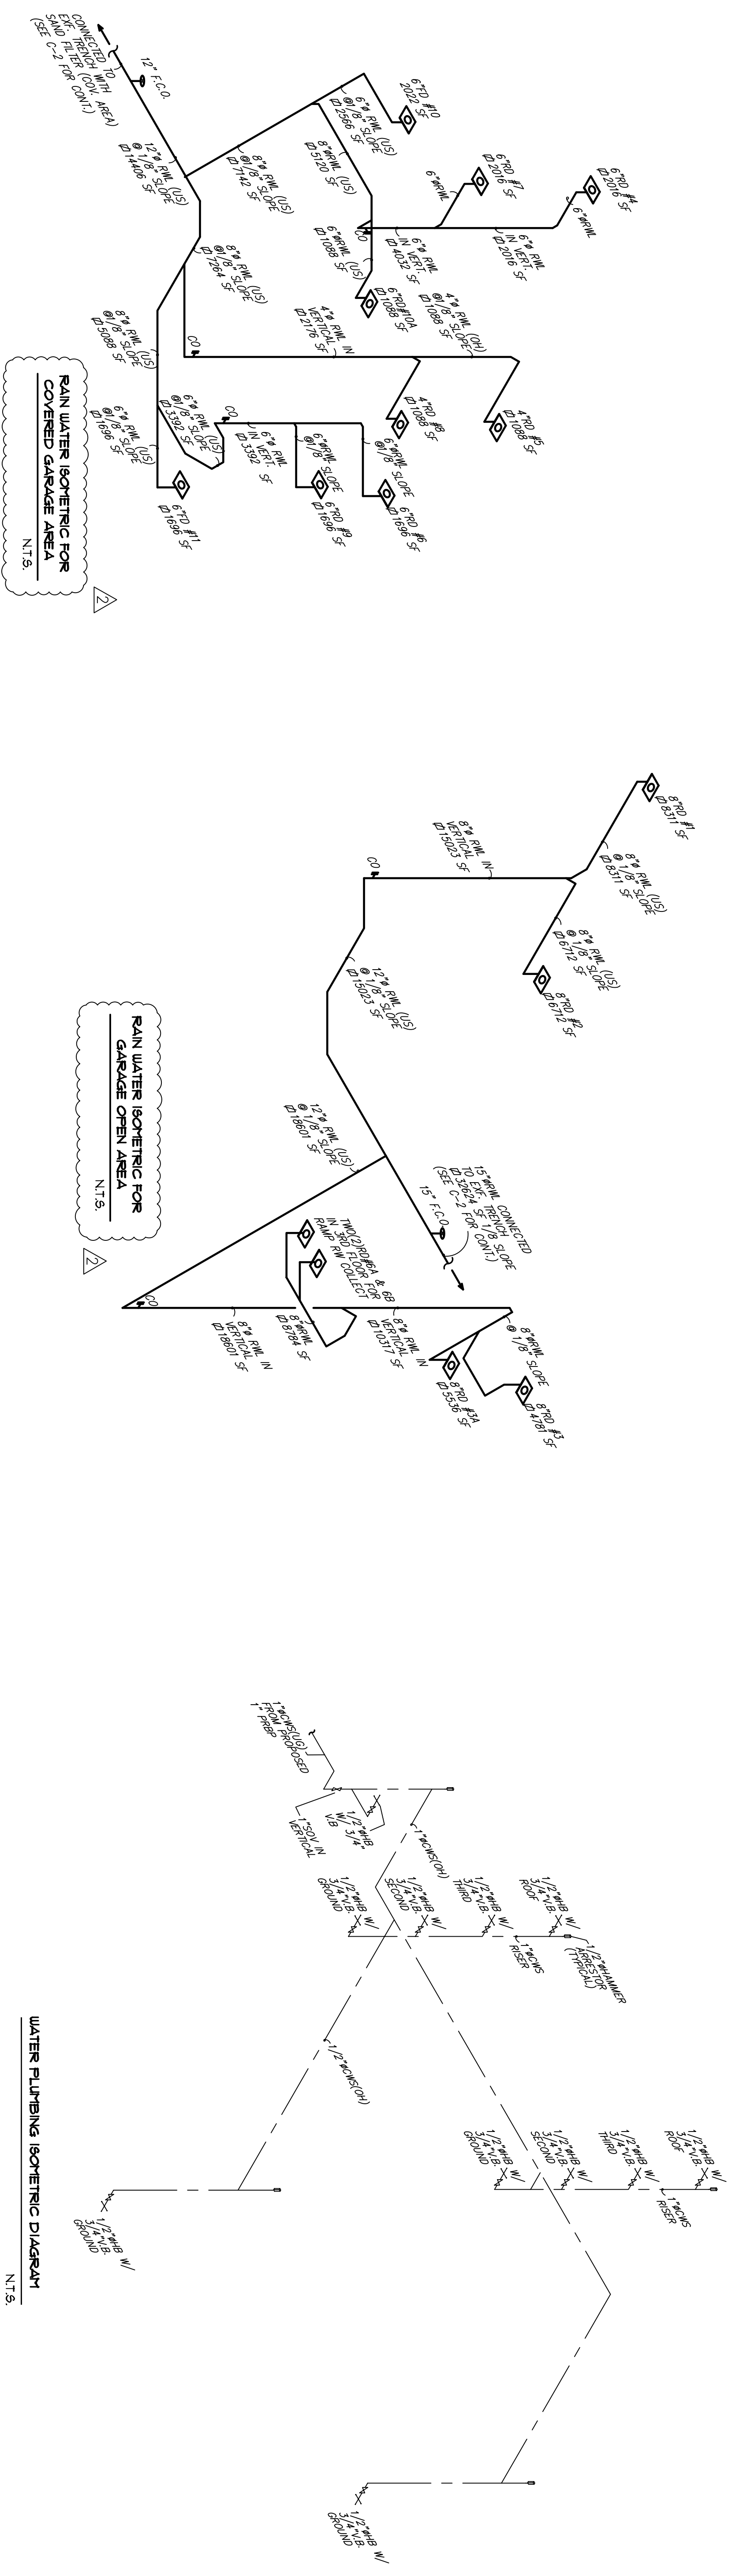

ROOF PLUMBING PLAN
SCALE: 3/32" = 1'-0"



City of Hialeah
Construction and Maintenance
900 East 56th Street Bldg. 1
HIALEAH, FLORIDA 33013
Tel: (305) 687-2682
Fax: (305) 687-2642

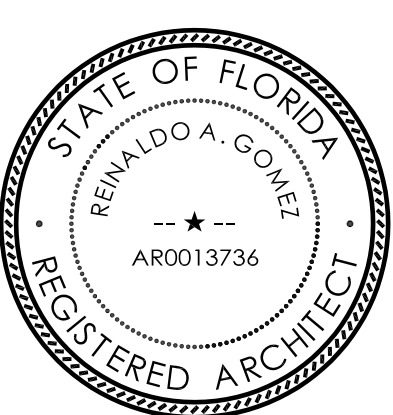

City Architect
REINALDO A GOMEZ
LIC. AR0013736

PROJECT No.
1004

PALM CENTER GARAGE

PROJECT ADDRESS:
HIALEAH, FL

CONSULTANTS

GURROLA & ASSOCIATES P.A.
ARCHITECTS

P.E. No. 82285
Renaldo A. Gomez
Prof. Engineer

SEAL
REINALDO A. GOMEZ
NATIONAL BOARD OF ARCHITECTS
EX. 10000112
EMAIL: RGOMEZ@GURROLA.COM

NO.	DATE	REVISION
1	8/3/10	ARCH. CHANGES
2	2/9/11	B. D. COMMENTS

DATE: 05-12-2010
SCALE: AS SHOWN
DRAWN BY:
CHECKED BY:
R.G.

SHEET TITLE
This drawing is property of the City of Hialeah and is not to be reproduced or copied in whole or part. It is not to be used on any other project and is to be used only when approved.

SHEET NUMBER
P-4

ADDENDUM RECEIPT FORM

**CITY OF HIALEAH
PALM CENTER PARKING GARAGE**

PLUMBING (BID # 2009/10-3230-00-091)

CONTRACTOR'S NAME _____

ADDRESS _____

PHONE NO. _____ **FAX NO.** _____

CONTACT NAME _____ **E-MAIL** _____

THE BIDDER ACKNOWLEDGES RECEIPT OF THE FOLLOWING ADDENDUM BY SIGNING AND DATING BELOW: (COPY OF THIS FORM MUST BE FAXED AND IMMEDIATELY TO CITY of HIALEAH @ (305) 687-2642

<u>ADDENDUM</u>	<u>SIGNATURE</u>	<u>DATE</u>
20	_____	_____
_____	_____	_____
_____	_____	_____
ARF