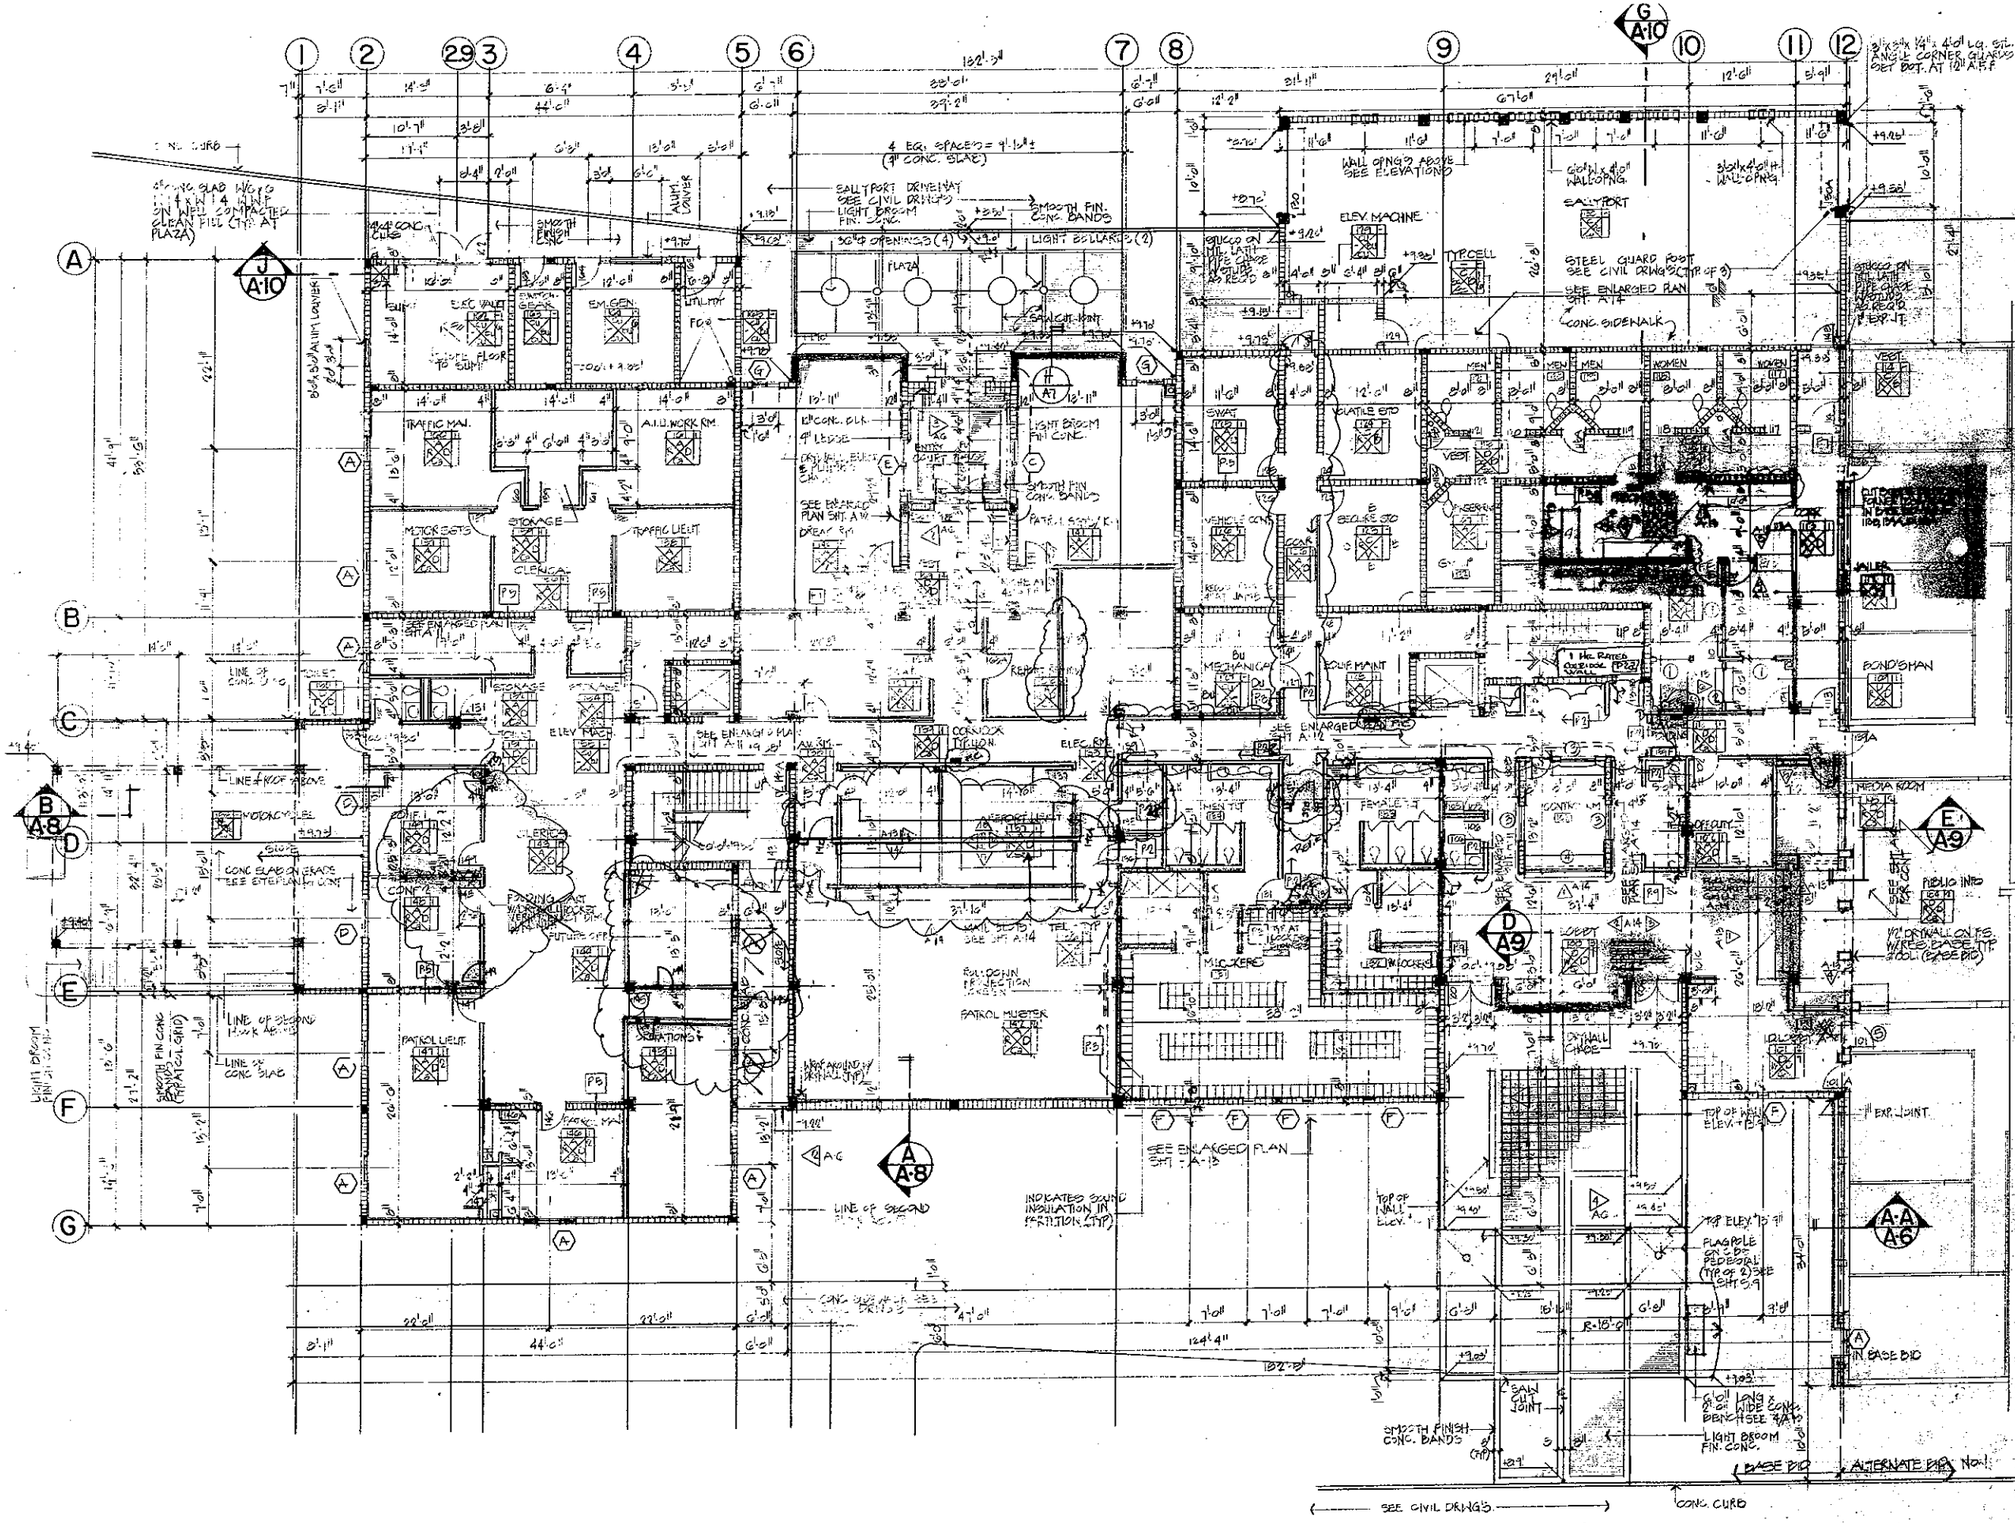

FIRST FLOOR PLAN 1/8"=1'-0"

FIRST FLOOR ELEV. 0.0' = ELEV. +9.00' TYP. U.O.N.

ROOM FINISH SYMBOL LEGEND

P 101 2 — CEILING HEIGHT
A3 — GENERAL NOTES
R2 — WALL MATERIAL WHEN WALLS ARE ALL ALIKE
V 3 4 P
RC — WALL MATERIAL INDICATION OCCURS OUTSIDE OF SQUARE WHEN WALL MATERIAL DIFFERS
ROOM NUMBER
CEILING
BASE
FLOOR

SUBMITTALS REQUIRED IF USED. REFERENCE FINISH SCHEDULE.
ALL SURFACES NOT FACTORY PRE-FINISHED ARE PAINTED.
ALL SURFACES NOT PRE-FINISHED CONTAINING GLASS OR PLASTIC ARE TO BE INSTALLED CONTINUOUS AND NOT CONTINUOUS ACROSS PRE-FINISHED.

FINISH SCHEDULE ABBREVIATIONS

A	ACOUSTICAL TILE
B	BLOCK, CONCRETE PAINTED
BU	BLOCK, CONCRETE UNPAINTED
C	CONCRETE, PAINTED
Ca	CARPETING
CU	CONCRETE, UNPAINTED
D	DRYWALL, PAINTED
DU	DRYWALL, UNPAINTED
E	EPOXY COATING
Fp	FOLDING PARTITION
GB	GLAZED CONCRETE BLOCK
Gl	GLASS
M	METAL, PREFINISHED
MP	METAL, PAINTED
Mx	METAL, EXPANDED
N	NONE
Pa	PLASTER, ACOUSTICAL
Pc	PLASTER, CEMENT PAINTED
PcU	PLASTER, CEMENT UNPAINTED
Pd	PLYWOOD
Ps	PLASTER, SKIMCOAT PAINTED
PsU	PLASTER, SKIMCOAT UNPAINTED
Px	PATCH TO MATCH EXISTING
Q	QUARRY TILE/BASE (HIGH)
R	RESILIENT BASE (4" HIGH)
S	SEAMLESS FLOORING
Sc	SPECIAL COATINGS
St	STONE
T	TILE, CERAMIC/BASE (HIGH)
Tc	TILE, CLAY UNGLAZED
Tt	TERRAZZO
U	UNFINISHED
V	VINYL COMPOSITION TILE
X	EXISTING
W	WOOD (2" x 3 1/2" PAINTED)

CEILING HEIGHTS

1. 7'-10" A.F.F.
2. 9'-0" A.F.F.
3. 13'-0" A.F.F.
4. 13'-6" A.F.F.

GENERAL NOTES

1. DEX-O-TEX NEOTEX LATEX CUTPOO TION SEAMLESS FLOORING AND BASE.
2. IN CLOSETS SCHED TO RECEIVE SHELVING PROVIDE 1 PLASTIC COVERED MTL. OPEN SH. W/INTEGRAL ROD.
3. PROVIDE 4-4"ø SS RINGS SECURE TO WALL ABOVE BENCHES SEE ELEVATION 12 ON SHT. A-13.
4. ALL INTERIOR FINISHES SHALL HAVE A FLAME SPREAD CLASSIFICATION AS FOLLOWS:
   A. CORRIDORS, MEANS OF EGRESS (CLASS B) 26-75
   B. OFFICES (CLASS C) 76-200
5. ALL INTERIOR PARTIAL PARTITIONS ARE P1 U.O.N.
6. FILL CELLS W/CONC. IN ELEC. VAULT, EM. GEN. RM., D.G. CELLS AND CONTROL RM.
7. VINYL WALL COVERING ALL WALLS IN LOBBY 100, LO LOBBY 101 CONT. AT CORRIDORS NEXT TO CONTROL ROOM.

CONTRACT
PROJECT RECORD
CONTRACTOR: Acme Western Corp.
BASED UPON INSPECTION AND REVIEW CONTRACT DRAWINGS AND FILES I CERTIFY THAT THIS DRAWING DEPICTS THE AS BUILT CONFIGURATION
(SIGNATURE) (DATE) (RESIDENT ENGINEER) B.B.PB
(SIGNATURE) (DATE) (CONTR. PROJ. MGR.)

MOLBERG ALVAREZ AND ASSOCIATES
ARCHITECTS PLANNERS
2000 NW 7 AVENUE MIAMI, FLORIDA 33127 PHONE 576-0195

POLICE ADMINISTRATION BUILDING
CITY OF HIALEAH

PUBLIC WORKS COMPLEX LE JEUNE AVE. AND EAST 54TH AND 55TH STREET - HIALEAH

project number	102000
issue date	APR 14, 1986
sheet number	A-1

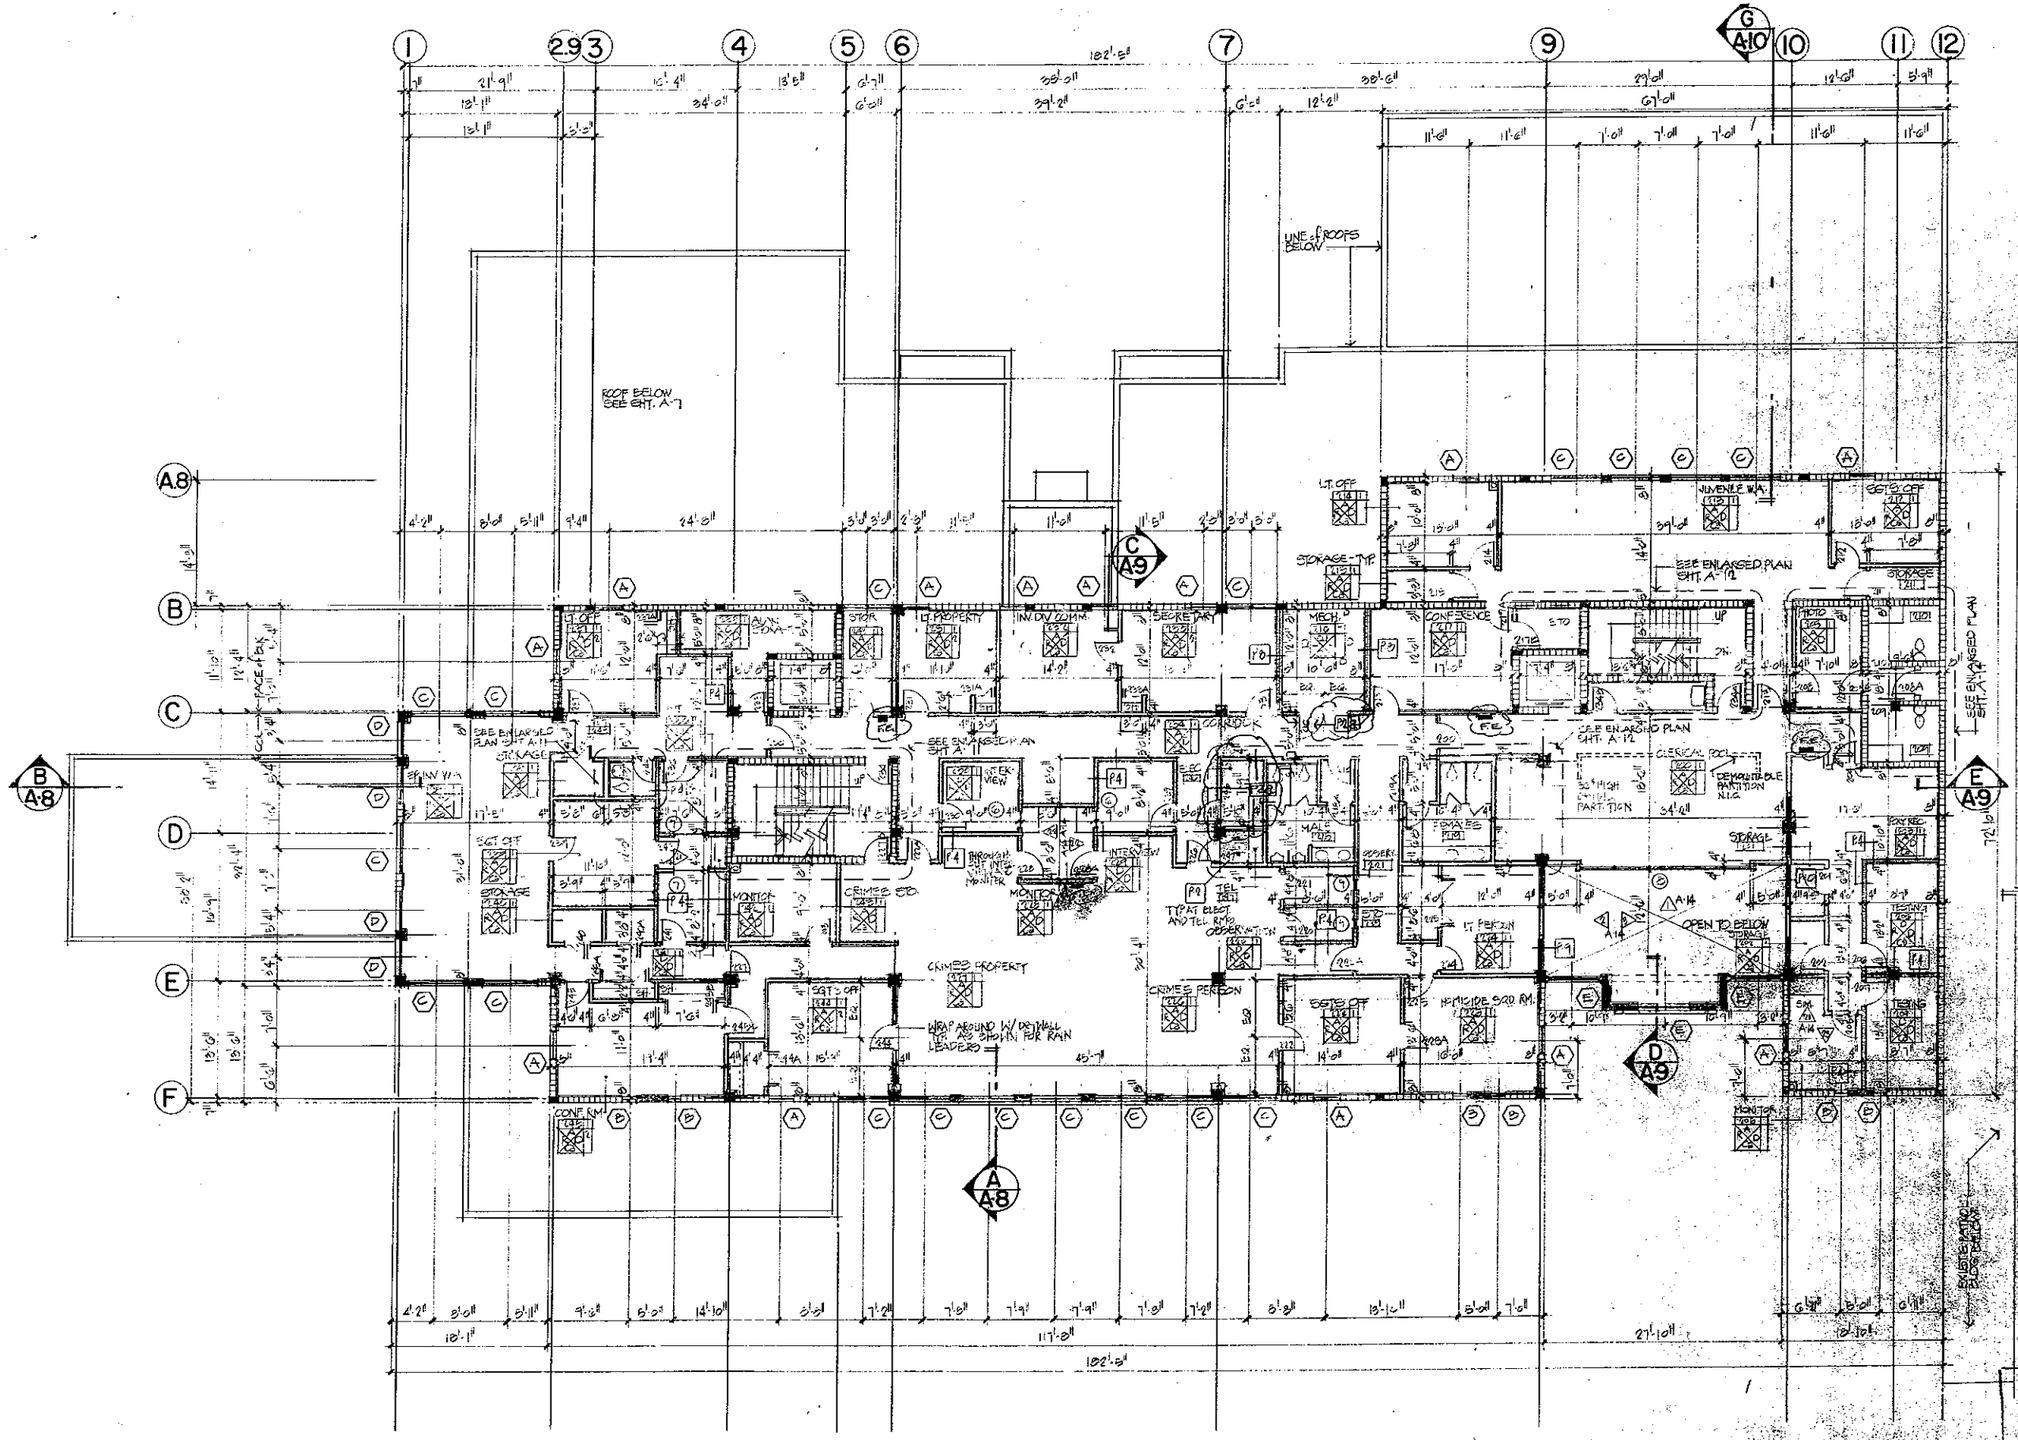

SECOND FLOOR PLAN 1/8"=1'-0"

ROOM FINISH SYMBOL LEGEND

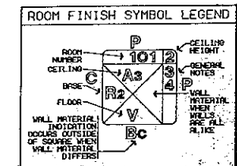

FINISH SCHEDULE ABBREVIATIONS

A	ACOUSTICAL TILE
B	BLOCK, CONCRETE PAINTED
BU	BLOCK, CONCRETE UNPAINTED
C	CONCRETE, PAINTED
Cc	CARPETING
CU	CONCRETE, UNPAINTED
D	DRYWALL, PAINTED
DU	DRYWALL, UNPAINTED
E	EPOXY COATINGS
Fp	FOLDING PARTITION
GB	GLAZED CONCRETE BLOCK
Gl	GLASS
M	METAL, PREFINISHED
MP	METAL, PAINTED
Me	METAL, EXPANDED
N	NONE
Po	PLASTER, ACOUSTICAL
Pc	PLASTER, CEMENT PAINTED
PcU	PLASTER, CEMENT UNPAINTED
Pd	PLYWOOD
Ps	PLASTER, SKIMCOAT PAINTED
PsU	PLASTER, SKIMCOAT UNPAINTED
Px	PATCH TO MATCH EXISTING
Q	QUARRY TILE/BASE (HIGH)
R	RESILIENT BASE (4" HIGH)
S	SEAMLESS FLOORING
Se	SPECIAL COATINGS
St	STONE
T	TILE, CERAMIC/BASE (HIGH)
Tc	TILE, CLAY UNGLAZED
Tt	TERRAZZO
U	UNFINISHED
V	VINYL COMPOSITION TILE
X	EXISTING

REFER TO SHT A1 FOR CEILING HEIGHTS AND GENERAL NOTES.

A. KOLBERG	
R. ALVAREZ	
A. KOLT	
A. SCOTT	

POLICE ADMINISTRATION BUILDING



Project No. 402000

CONTRACT PROJECT RECORD


BASED UPON INSPECTION AND REVIEW OF CONTRACT DRAWINGS AND FILES I CERTIFY THAT THIS DRAWING DEPICTS THE AS BUILT CONFIGURATION

6-8-88

A-2

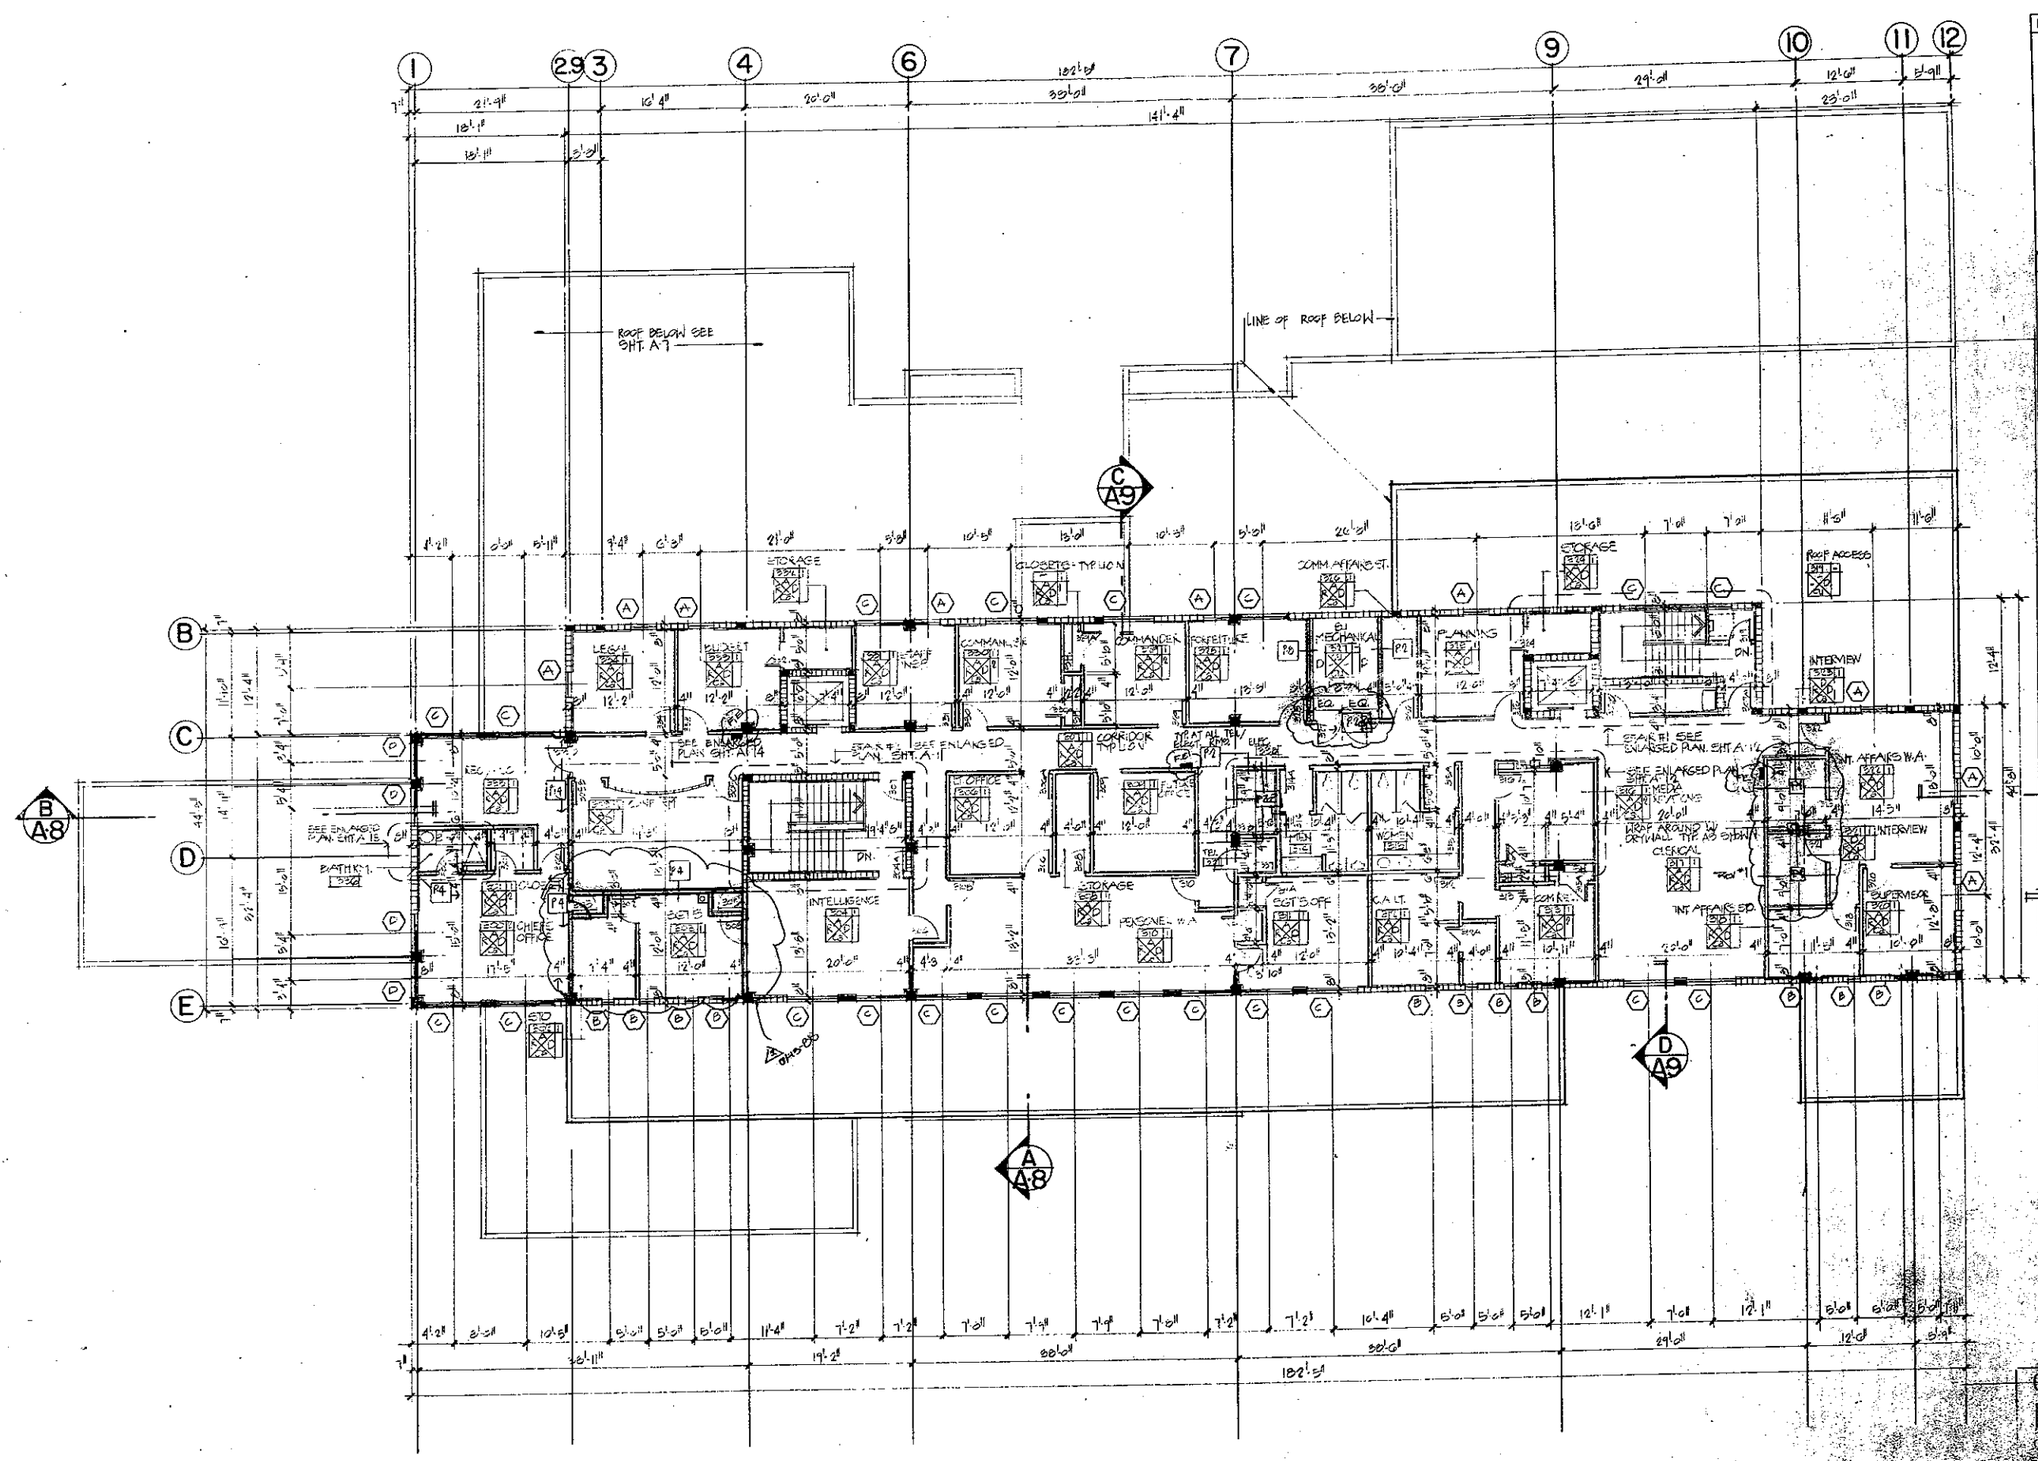

THIRD FLOOR PLAN 1/8"=1'-0"

ROOM FINISH SYMBOL LEGEND

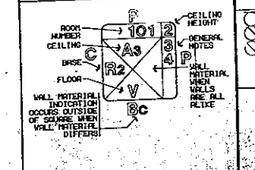


FINISH SCHEDULE ABBREVIATIONS

A	ACOUSTICAL TILE
B	BLOCK, CONCRETE PAINTED
BU	BLOCK, CONCRETE UNPAINTED
C	CONCRETE, PAINTED
Ca	CARPETING
CU	CONCRETE, UNPAINTED
D	DRYWALL, PAINTED
DU	DRYWALL, UNPAINTED
E	EPOXY COATING
Fp	FOLDING PARTITION
GB	GLAZED CONCRETE BLOCK
Gl	GLASS
M	METAL, PREFINISHED
MP	METAL, PAINTED
Mx	METAL, EXPANDED
N	NONE
Pa	PLASTER, ACOUSTICAL
Pc	PLASTER, CEMENT PAINTED
PcU	PLASTER, CEMENT UNPAINTED
Pd	PLYWOOD
Ps	PLASTER, SKIMCOAT PAINTED
PsU	PLASTER, SKIMCOAT UNPAINTED
Px	PATCH TO MATCH EXISTING
Q	QUARRY TILE/BASE (HIGH)
R	RESILIENT BASE (4" HIGH)
S	SEAMLESS FLOORING
Ss	SPECIAL COATINGS
St	STONE
T	TILE, CERAMIC/BASE (HIGH)
Tc	TILE, CLAY UNGLAZED
Tr	TERRAZZO
U	UNFINISHED
V	VINYL COMPOSITION TILE
X	EXISTING

REFER TO SHT. A-1 FOR CEILING HEIGHTS AND GENERAL NOTES.

POLICE ADMINISTRATION BUILDING
CITY OF HIALEAH

PUBLIC WORKS COMPLEX - LE JEUNE AVE. AND EAST 54TH AND 55TH STREETS

CONTRACT
PROJECT RECORD
CONTRACTOR: [illegible]
BASED UPON INSPECTION AND REVIEW OF CONTRACT DRAWINGS AND FILES, CONTRACTOR'S AS-BUILT DRAWINGS AND THIS AS-BUILT CONSTRUCTION.
[illegible] DATE

A-3

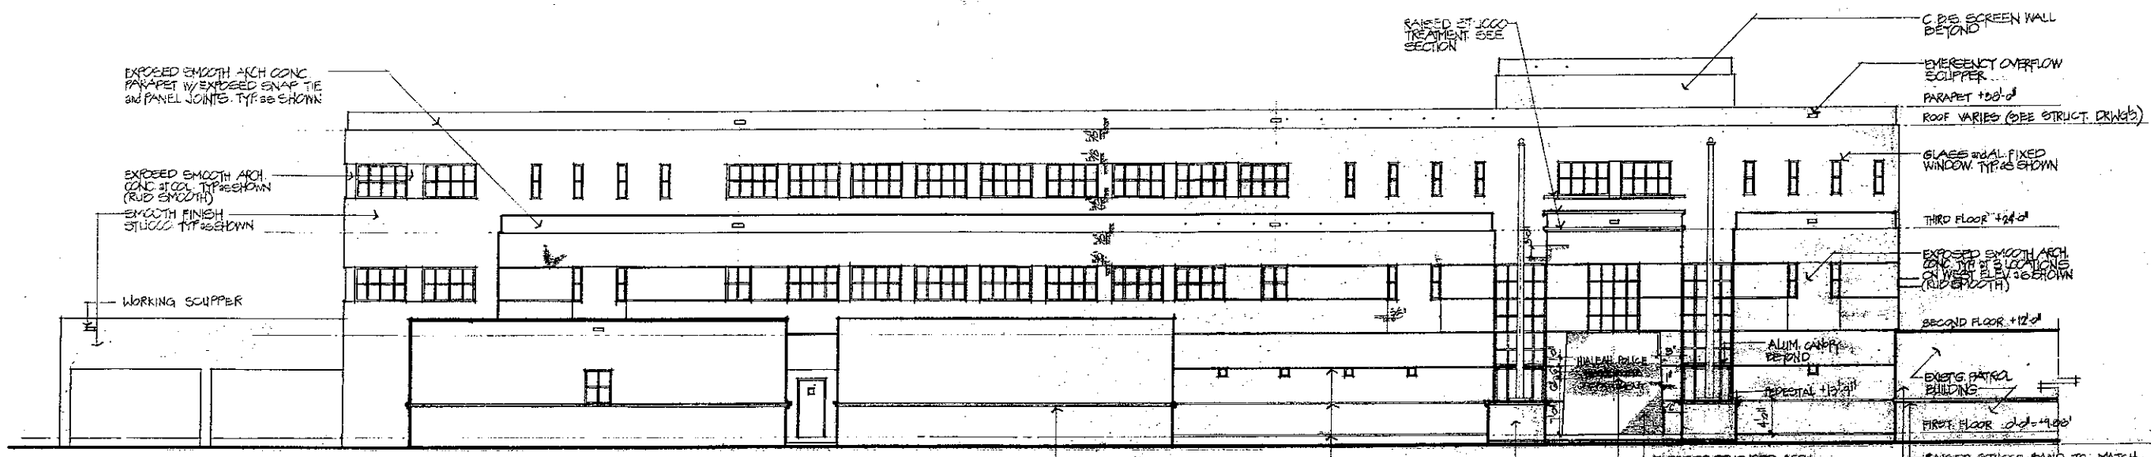

WEST ELEVATION 1/8"=1'-0"

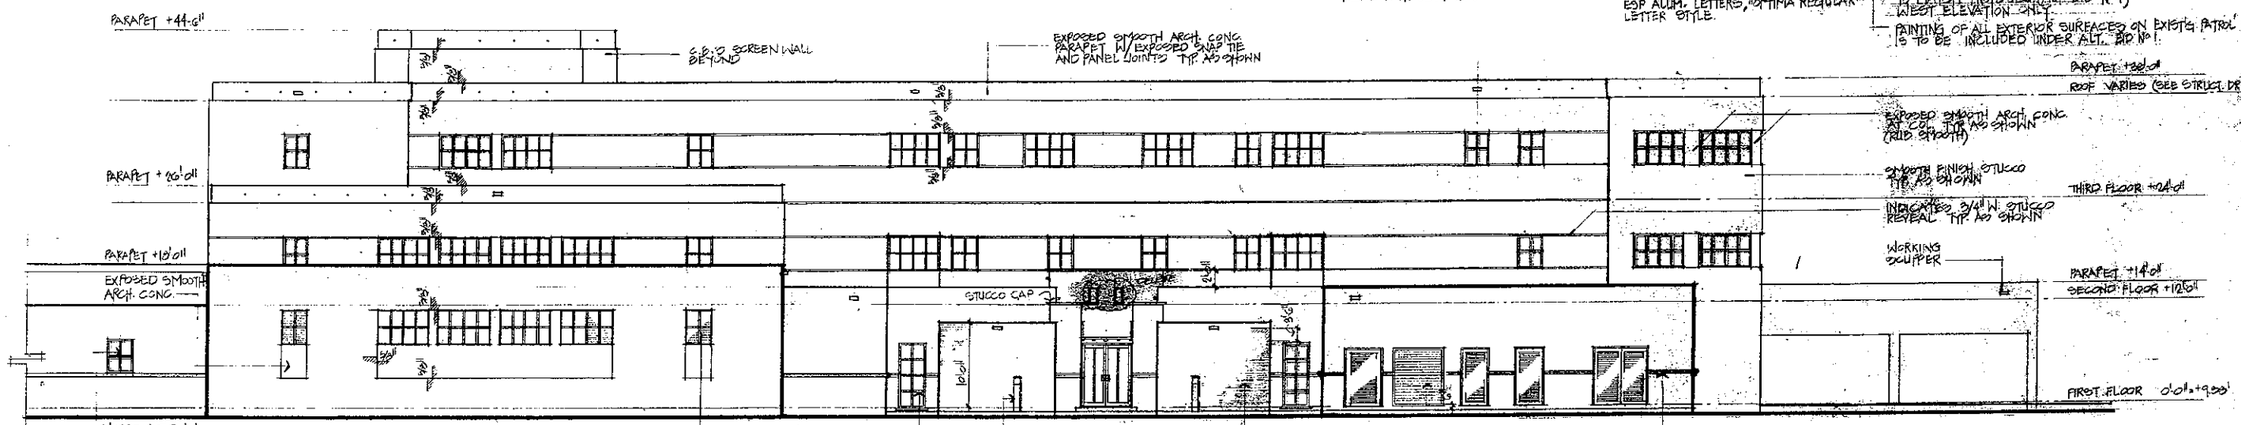

EAST ELEVATION 1/8"=1'-0"

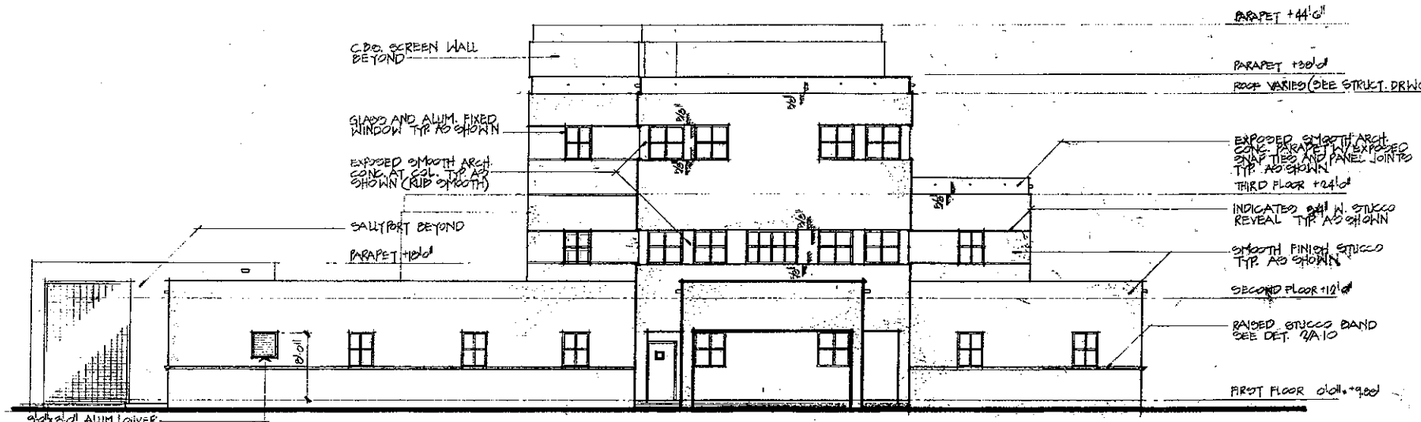

NORTH ELEVATION 1/8"=1'-0"

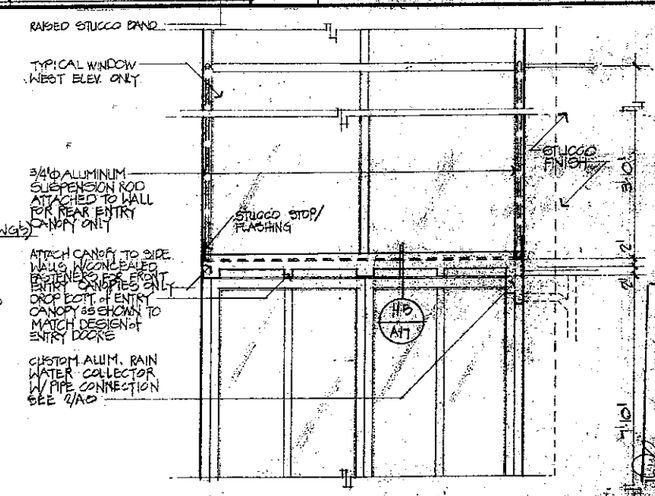

STOREFRONT/CANOPY ELEVATION 3/4"=1'-0"

EAST ENTRY SHOWN/REAR SIMILAR

NOTE: FIRST FLOOR ELEV. 0'-0" = ELEV. +9.00'

CONTRACT
PROJECT RECORD
CONTRACTOR: [illegible]
BASED UPON INSPECTION AND REVIEW OF CONTRACT DRAWINGS AND FIELD I CERTIFY THAT THIS DRAWING DEPICTS THE 'AS-BUILT' CONFIGURATION.
(SIGNATURE) (DATE) (PRE-BIDDING CONFERENCE)
[illegible] 5/4/00
(SIGNATURE) (DATE) (CONTRACTOR)

POLICE ADMINISTRATION BUILDING

CITY OF HIALEAH



DATE: 12-20-99
SCALE: 1/8"=1'-0"
DRAWN: [illegible]
CHECKED: [illegible]

A-5

2 OF 22

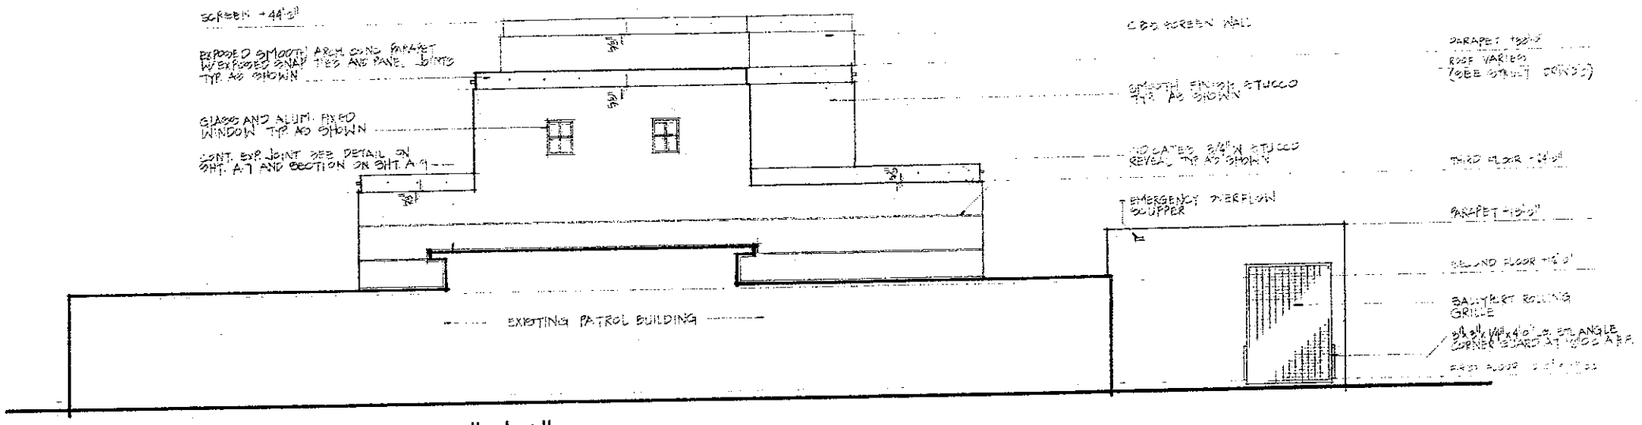

SOUTH ELEVATION 1/8"=1'-0"

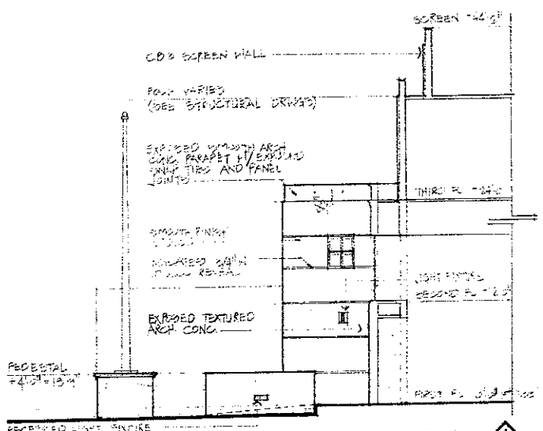

SOUTH INTERIOR ELEV. 1 1/8"=1'-0"

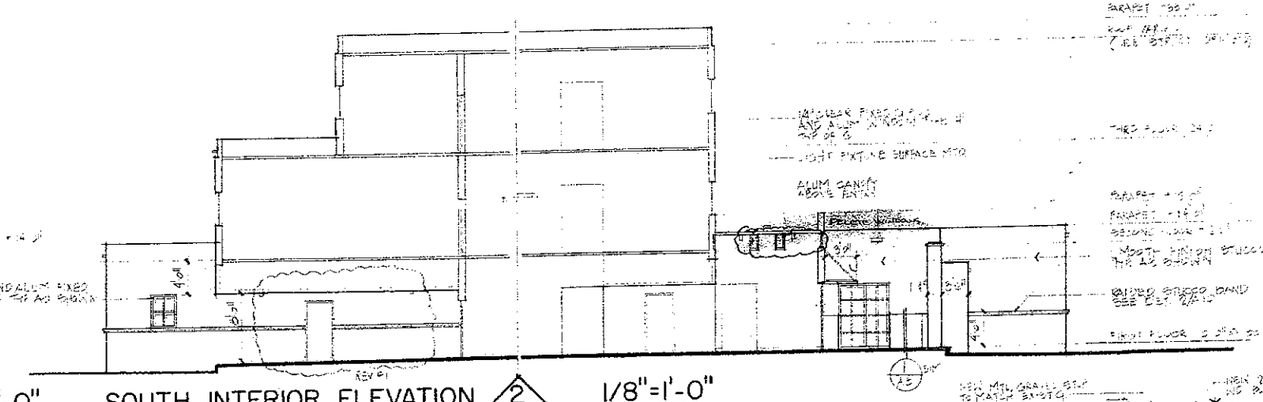

SOUTH INTERIOR ELEVATION 2 1/8"=1'-0"

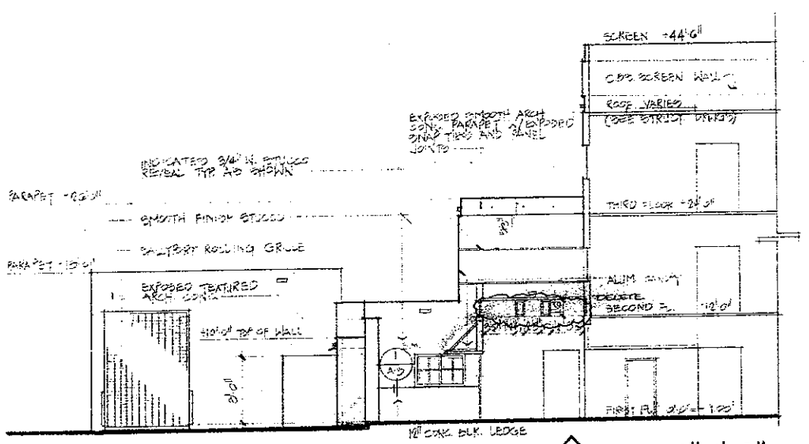

NORTH INTERIOR ELEVATION 3 1/8"=1'-0"

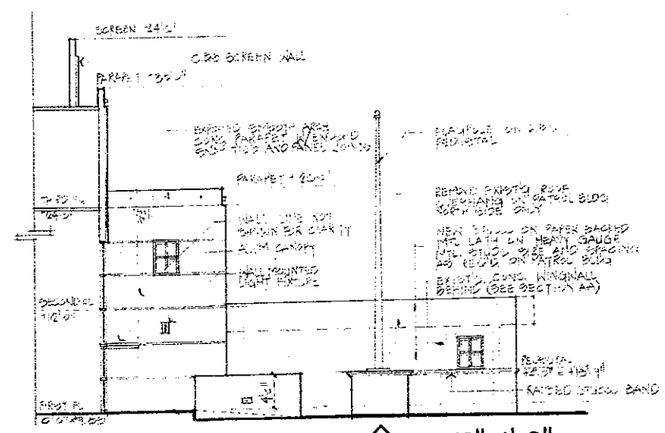

NORTH INTERIOR ELEV. 4 1/8"=1'-0"

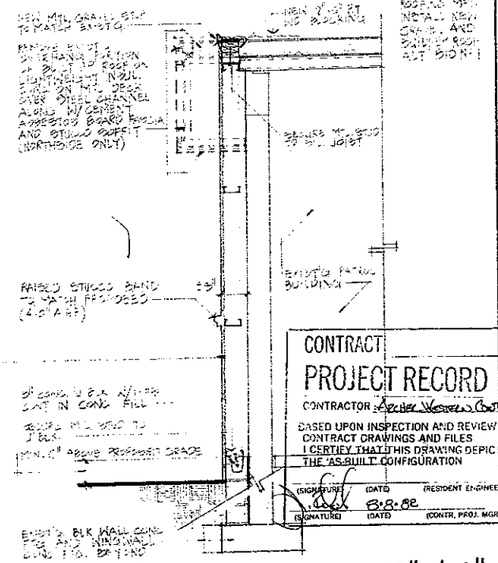

A-A WALL SECTION 1/2"=1'-0"

CONTRACT
PROJECT RECORD
CONTRACTOR Archer Western Contractors
BASED UPON INSPECTION AND REVIEW OF CONTRACT DRAWINGS AND FILES I CERTIFY THAT THIS DRAWING DEPICTS THE 'AS-BUILT' CONFIGURATION
(SIGNATURE) (DATE) (RESIDENT ENGINEER)
8-8-82
(SIGNATURE) (DATE) (CONTR. PROJ. MGR)

WOLFBERG ALVAREZ AND ASSOCIATES
5980 S.W. 57TH AVENUE
MIAMI, FLORIDA 33143
(305) 666-5474

POLICE ADMINISTRATION BUILDING
CITY OF HIALEAH
PUBLIC WORKS COMPLEX LE JEUNE AVE. AND EAST 54TH AND 55TH STREET - HIALEAH, FLORIDA

project number 402000

issue date
APR 4 '82
15 SEPT 80

sheet number
A-6